





T V Cabinet Downstairs
By
Malcolm N. Beasley
1985






T V Cabinet Downstairs
By
Malcolm N. Beasley
1985


Photo 2011

Malcolm & Wilma - Entertainment Center

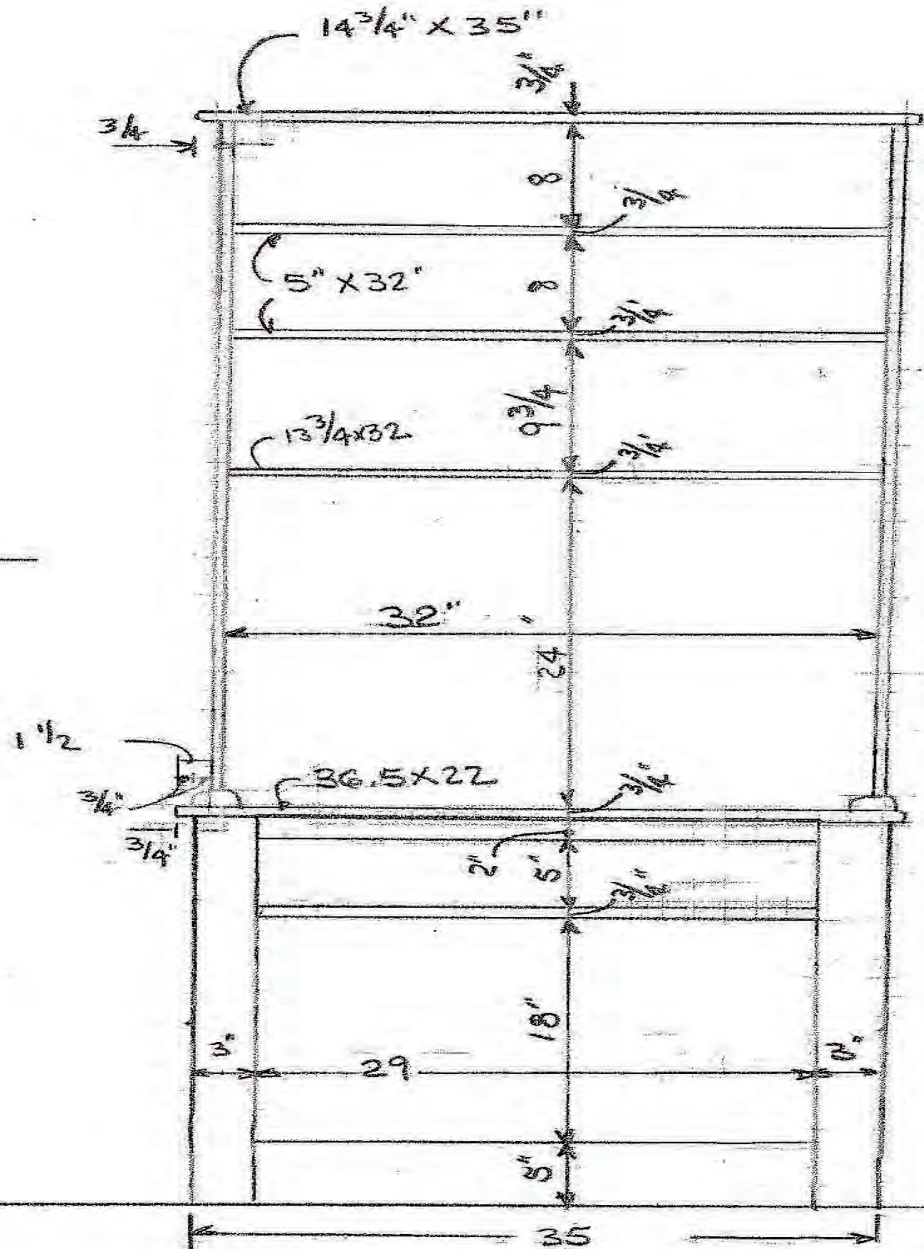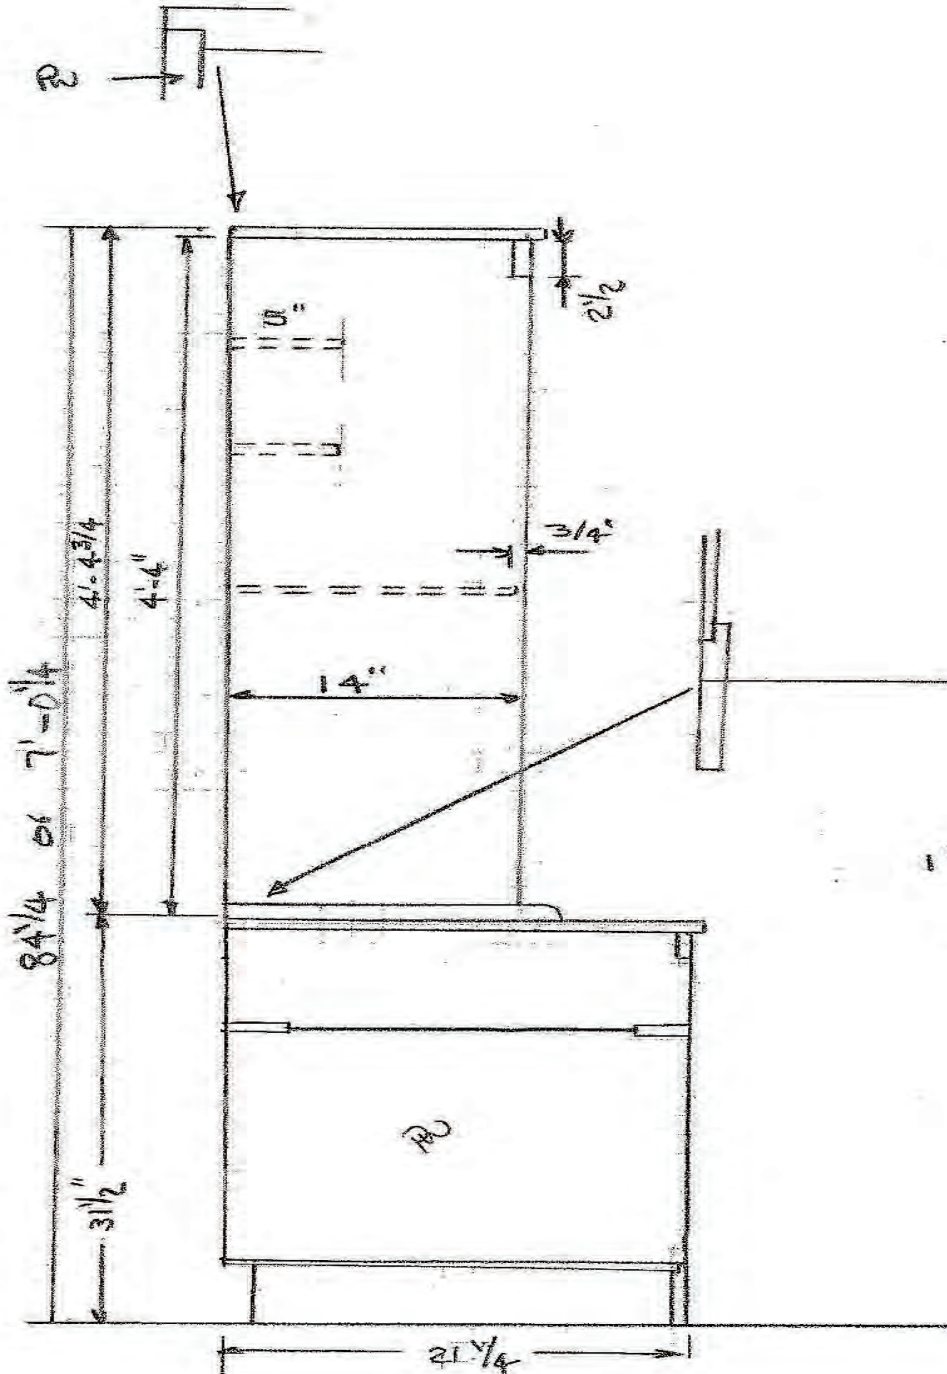

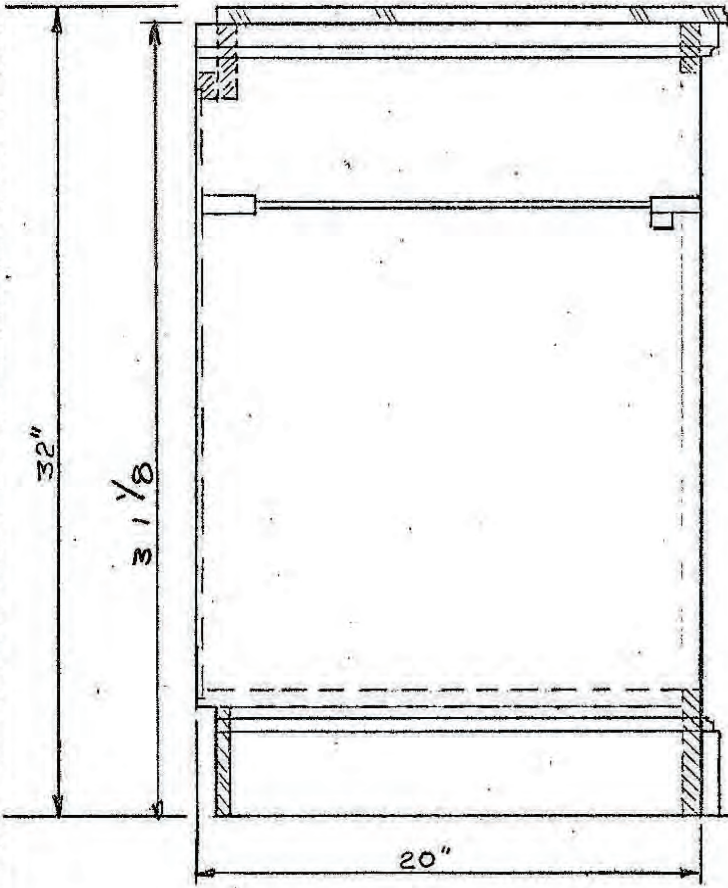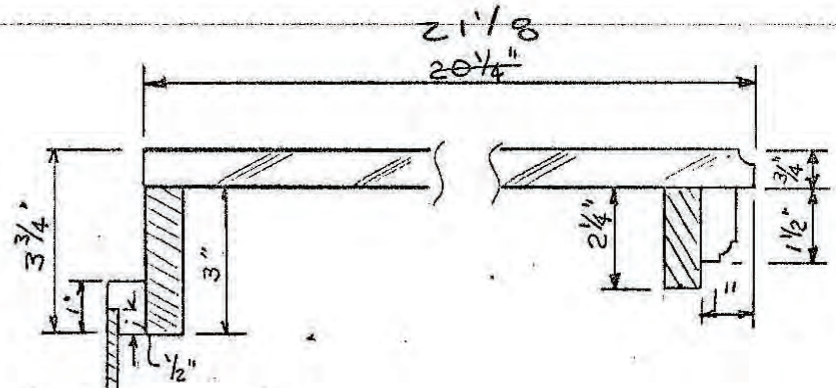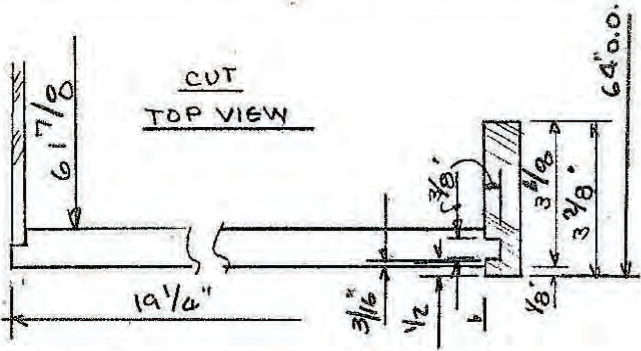

2 2 3/16" High
x 6 2 1/4" wide

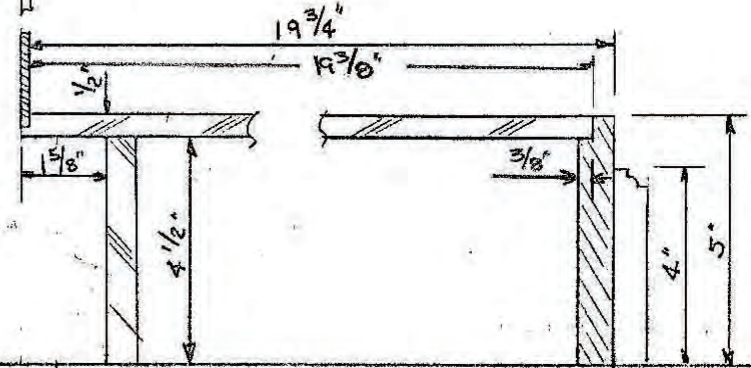

SIDE VIEW

CUT
SIDE VIEW