



Yard Table, Constructed by Malcolm Beasley 6-2002

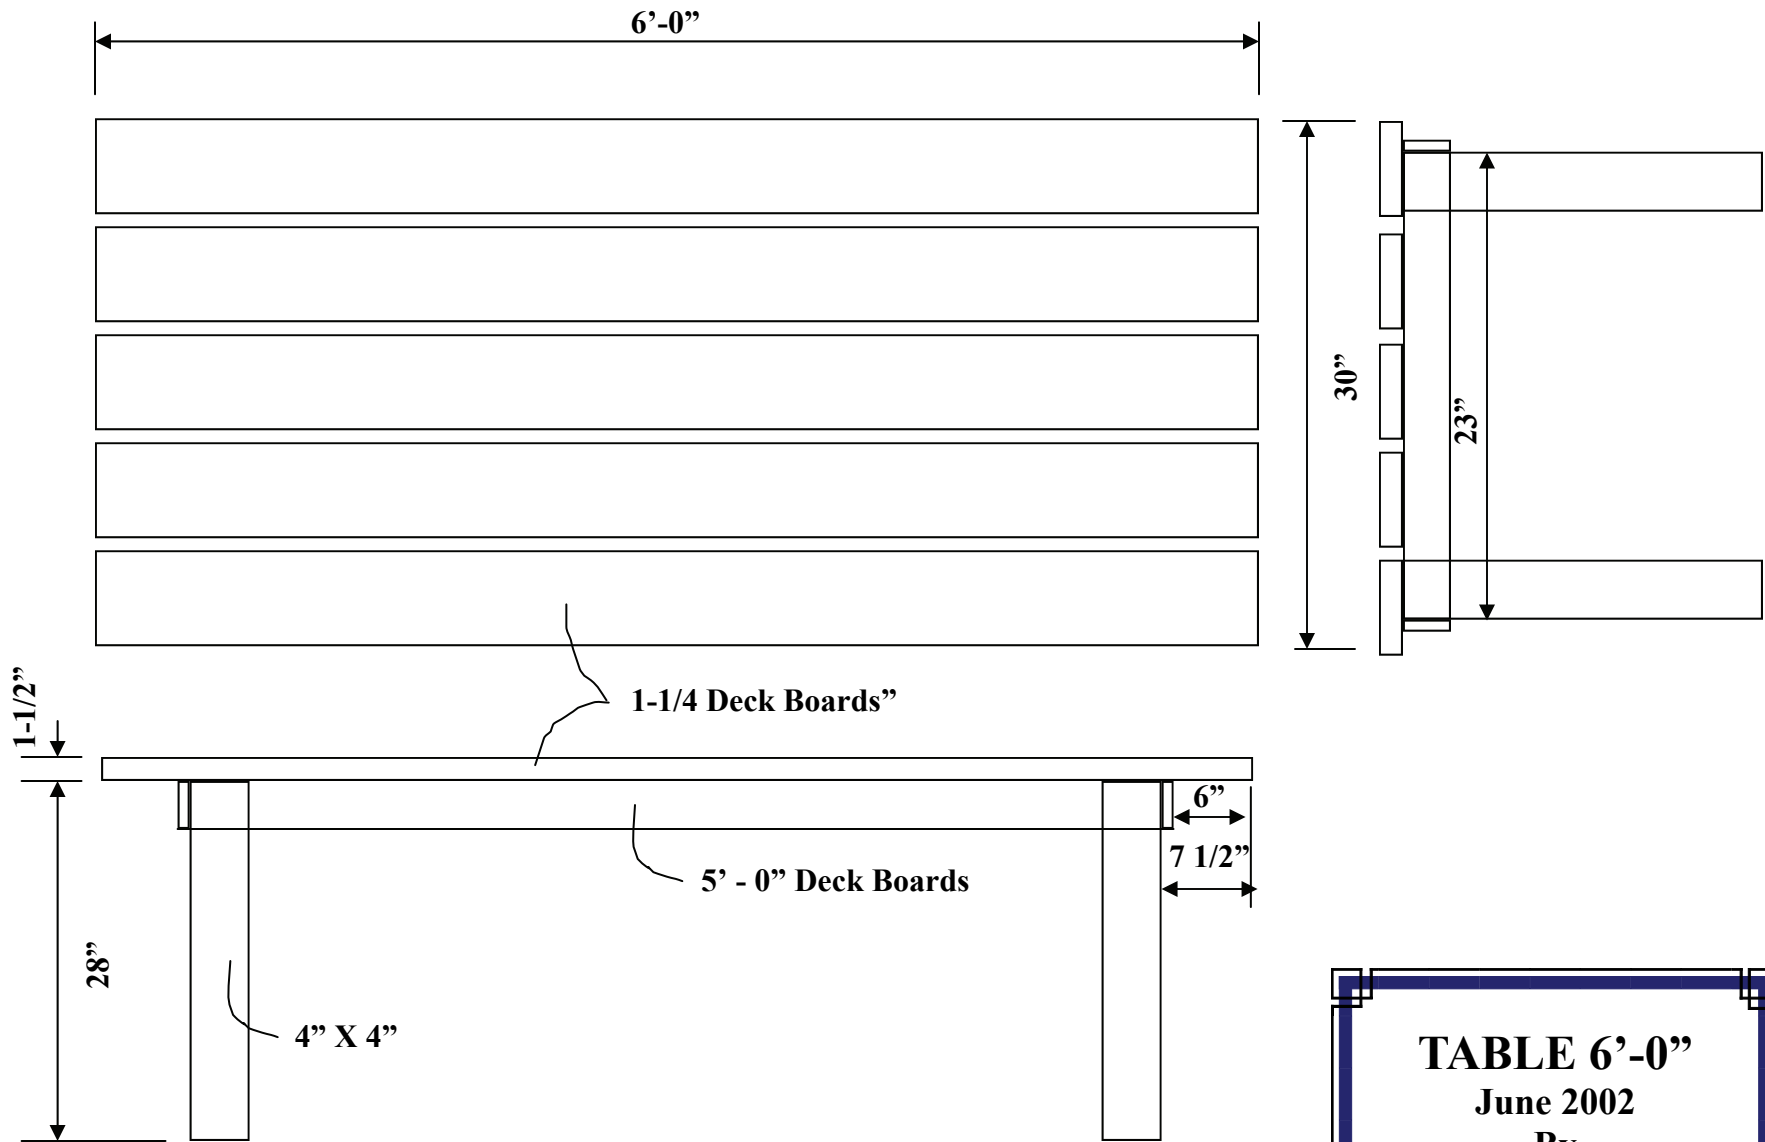


TABLE 6'-0"
 June 2002
 By
Malcolm N. Beasley