



FRONT VIEW


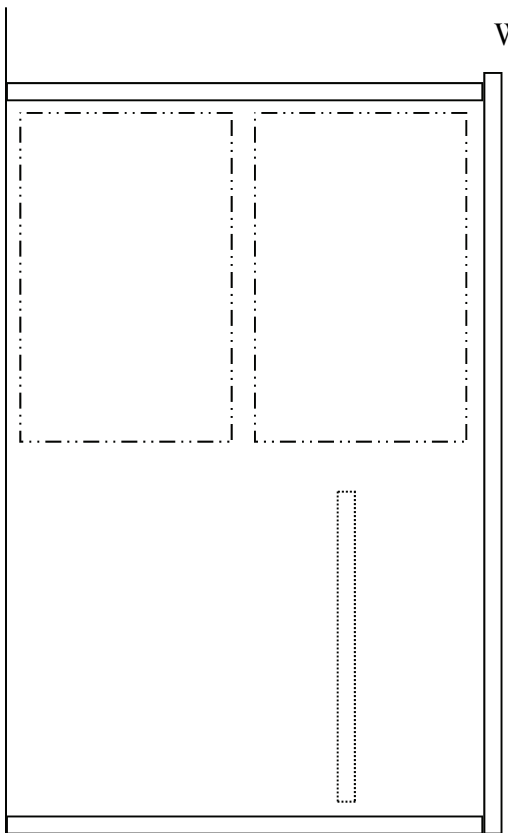


WINDOW

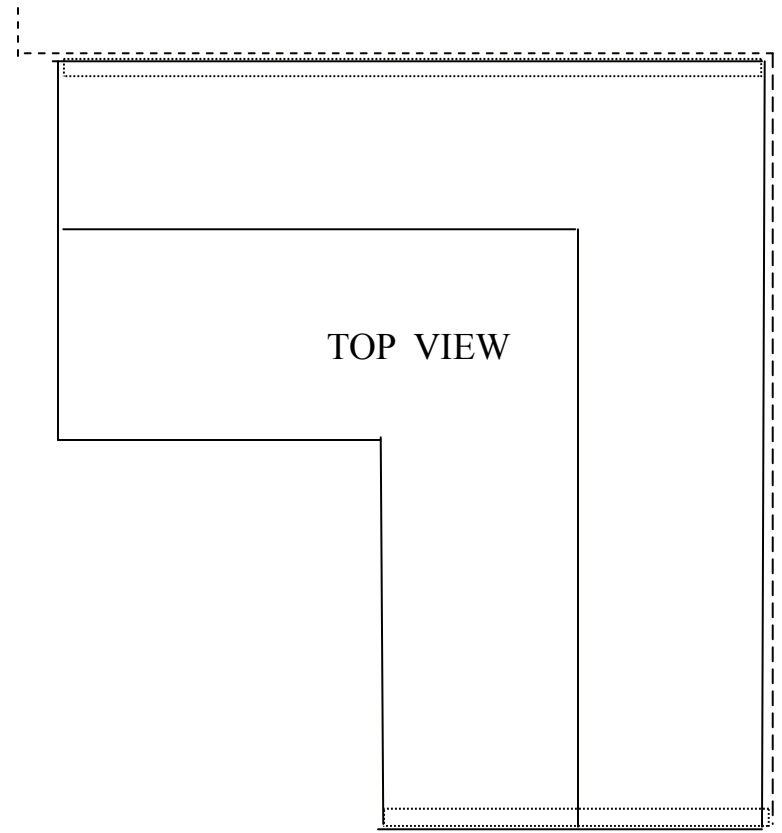

TOP VIEW


McNeil's Bedroom Ctr.
Feb 2004
By
Malcolm N. Beasley I & II
Page 1 of 3

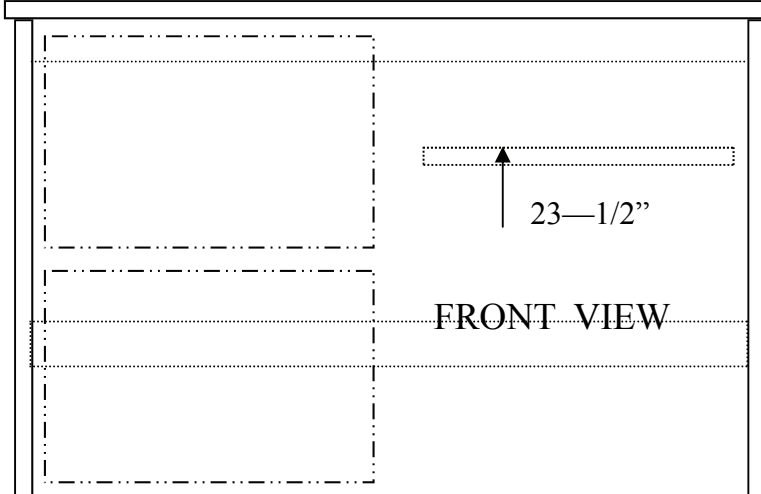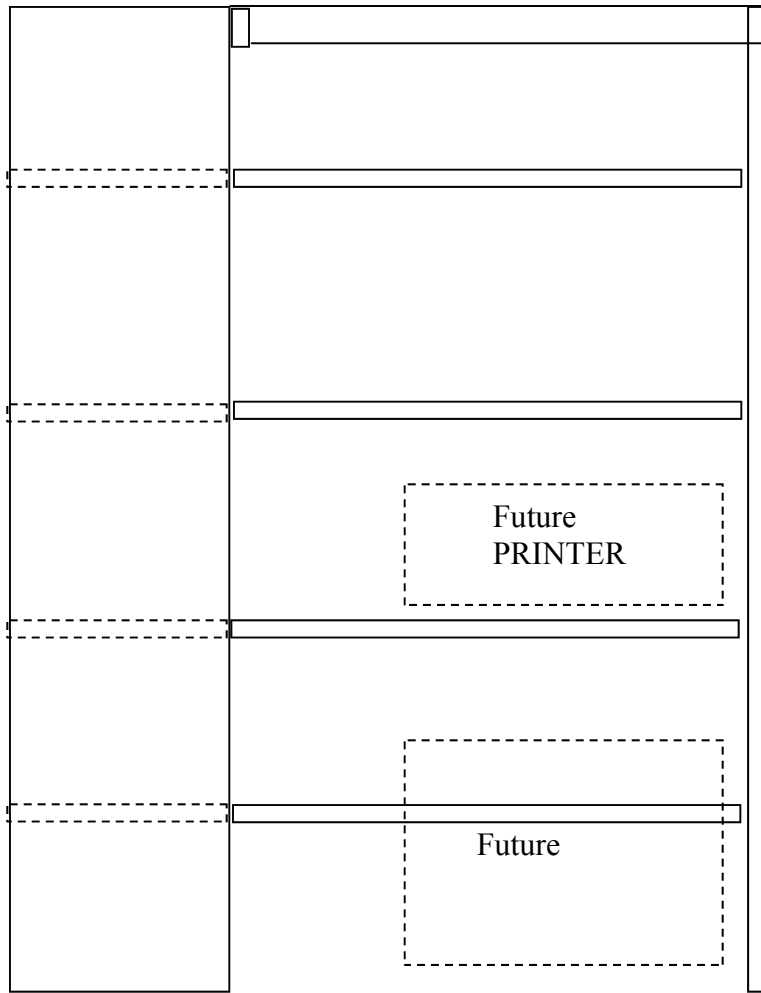

30"

24"




24"

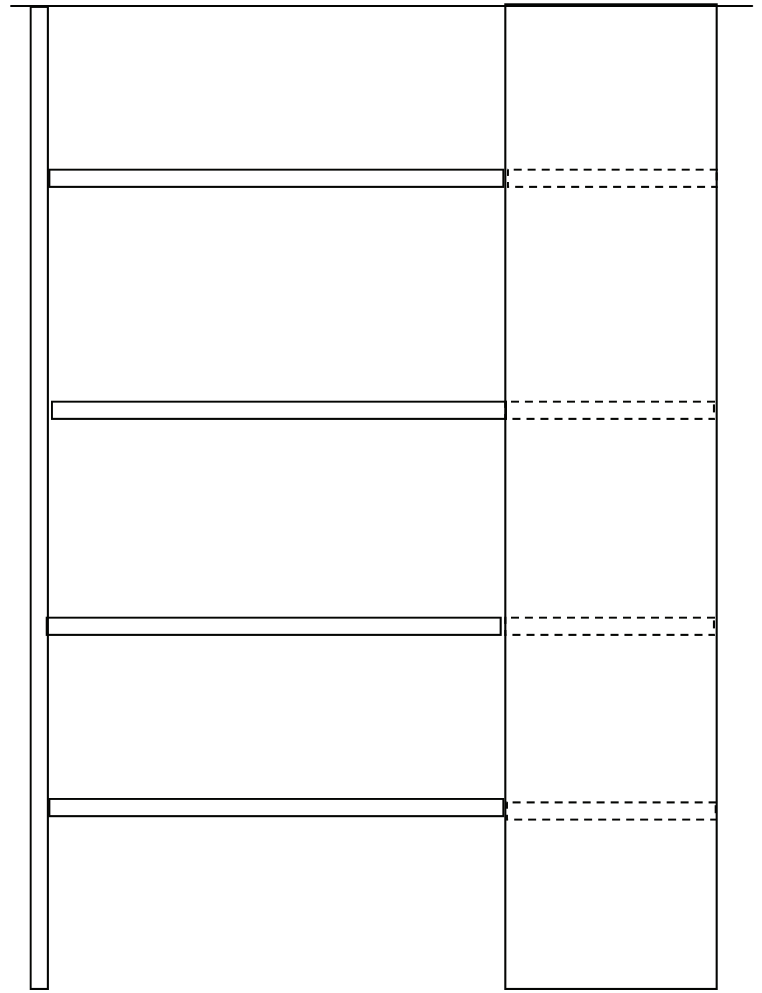

SIDE VIEW

12"

McNeil's Bedroom Ctr.
 Feb 2004
 By
 Malcolm N. Beasley I & II
 Page 2 of 3

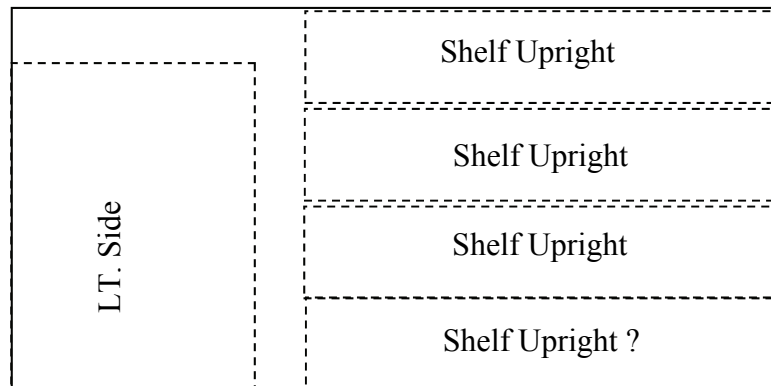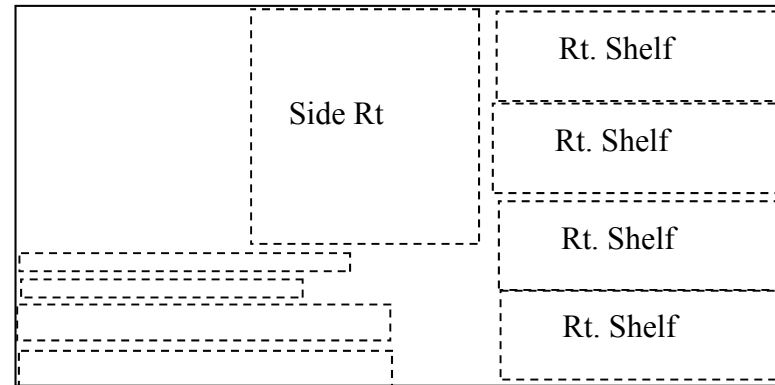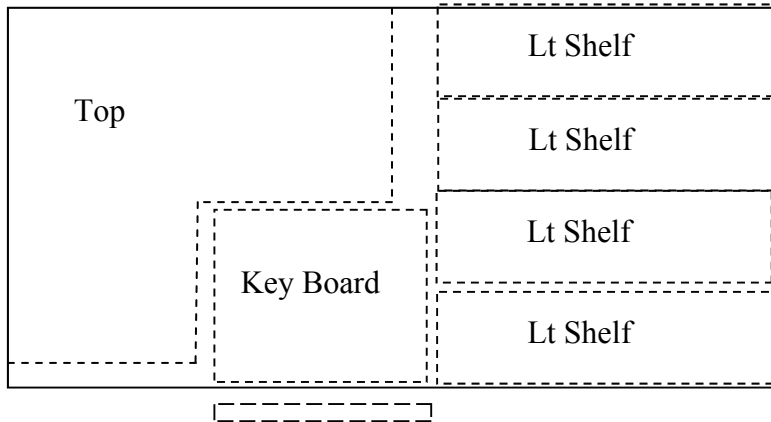

Materials:

- 3 Sheets Plywood
- 60 Lin Ft Edging
- 1 Set Drawer Rollers
- Stain
- Varnish