



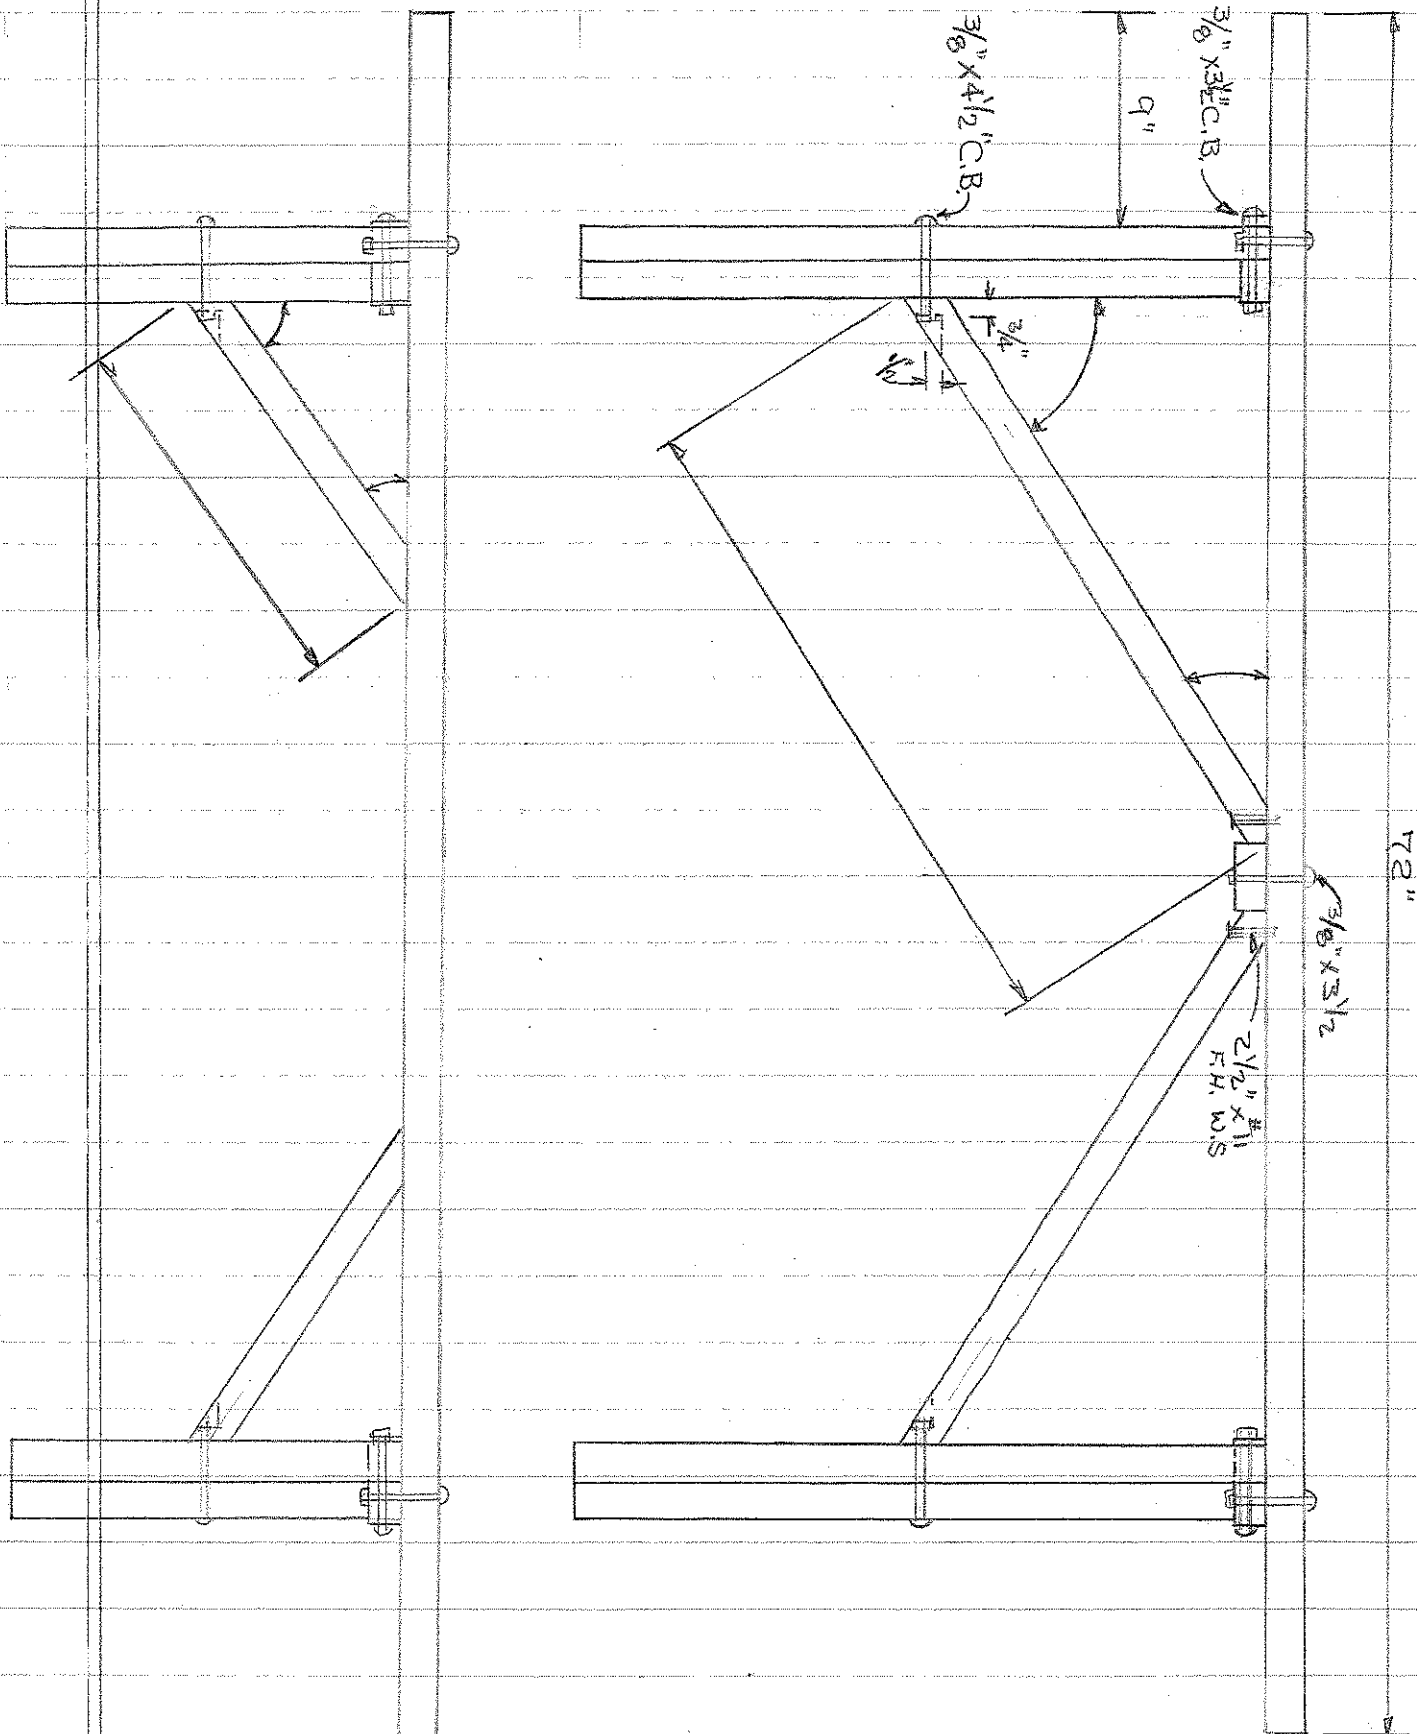


- 4 - 3/8" x 4 1/2" C.B
- 27 - 3/8" x 3 1/2" C.B
- 18 - 2 1/2" x #11 F.H.W.S.

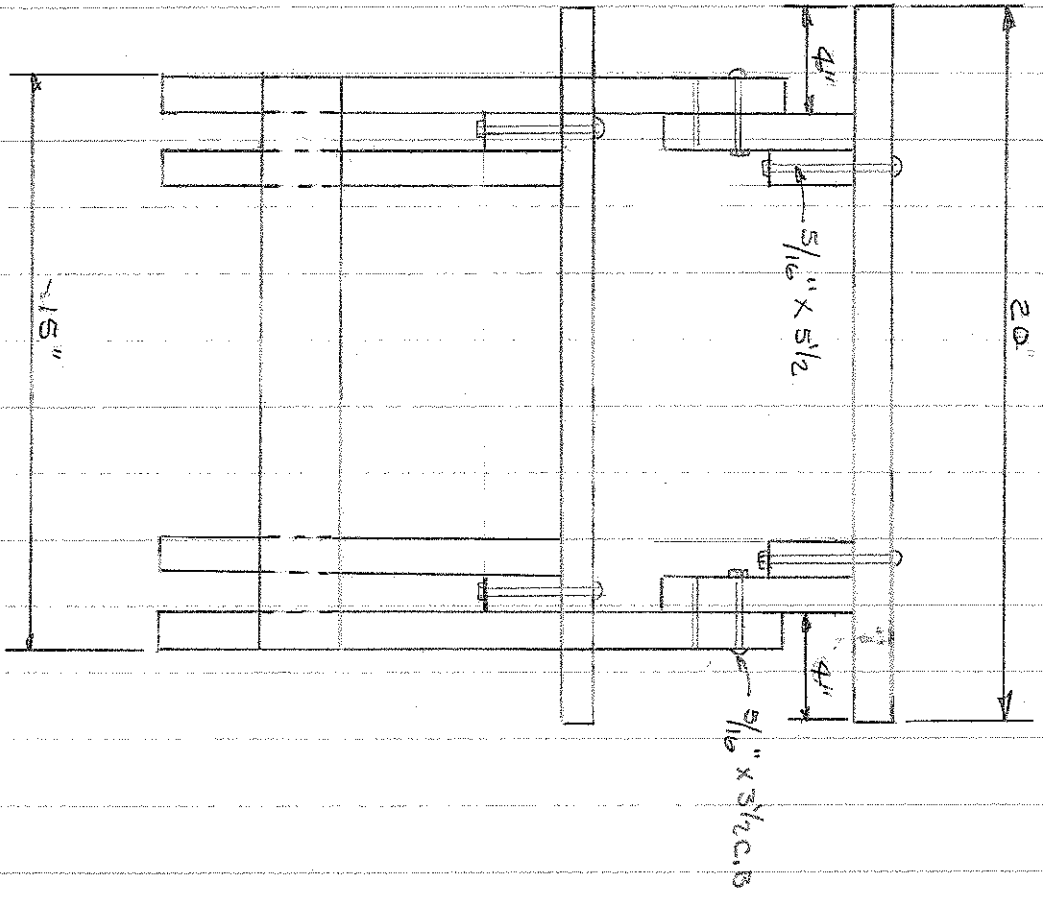

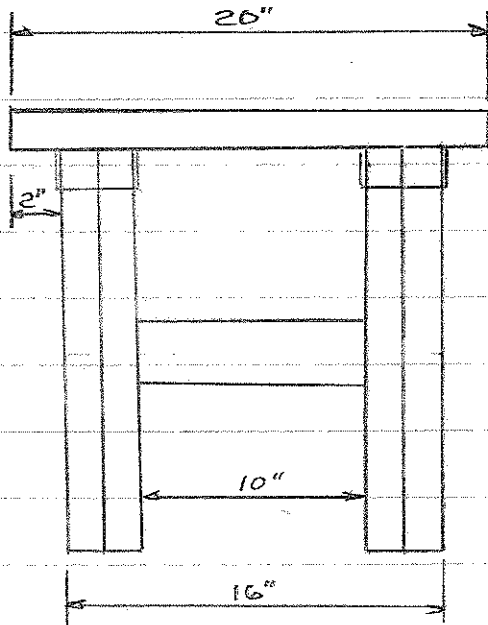

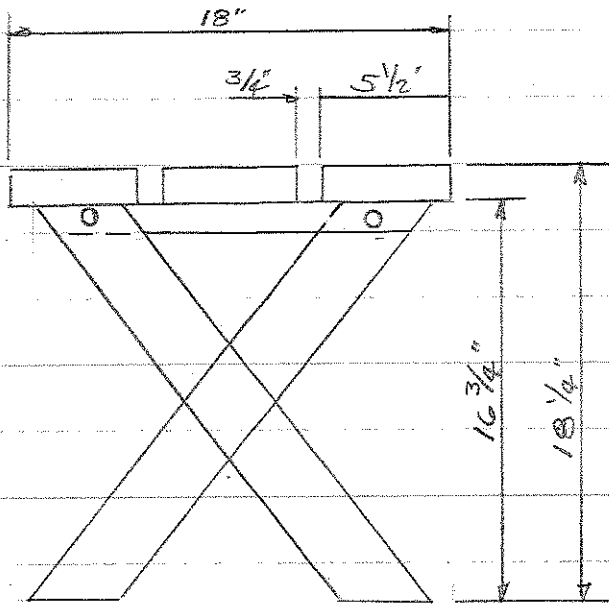

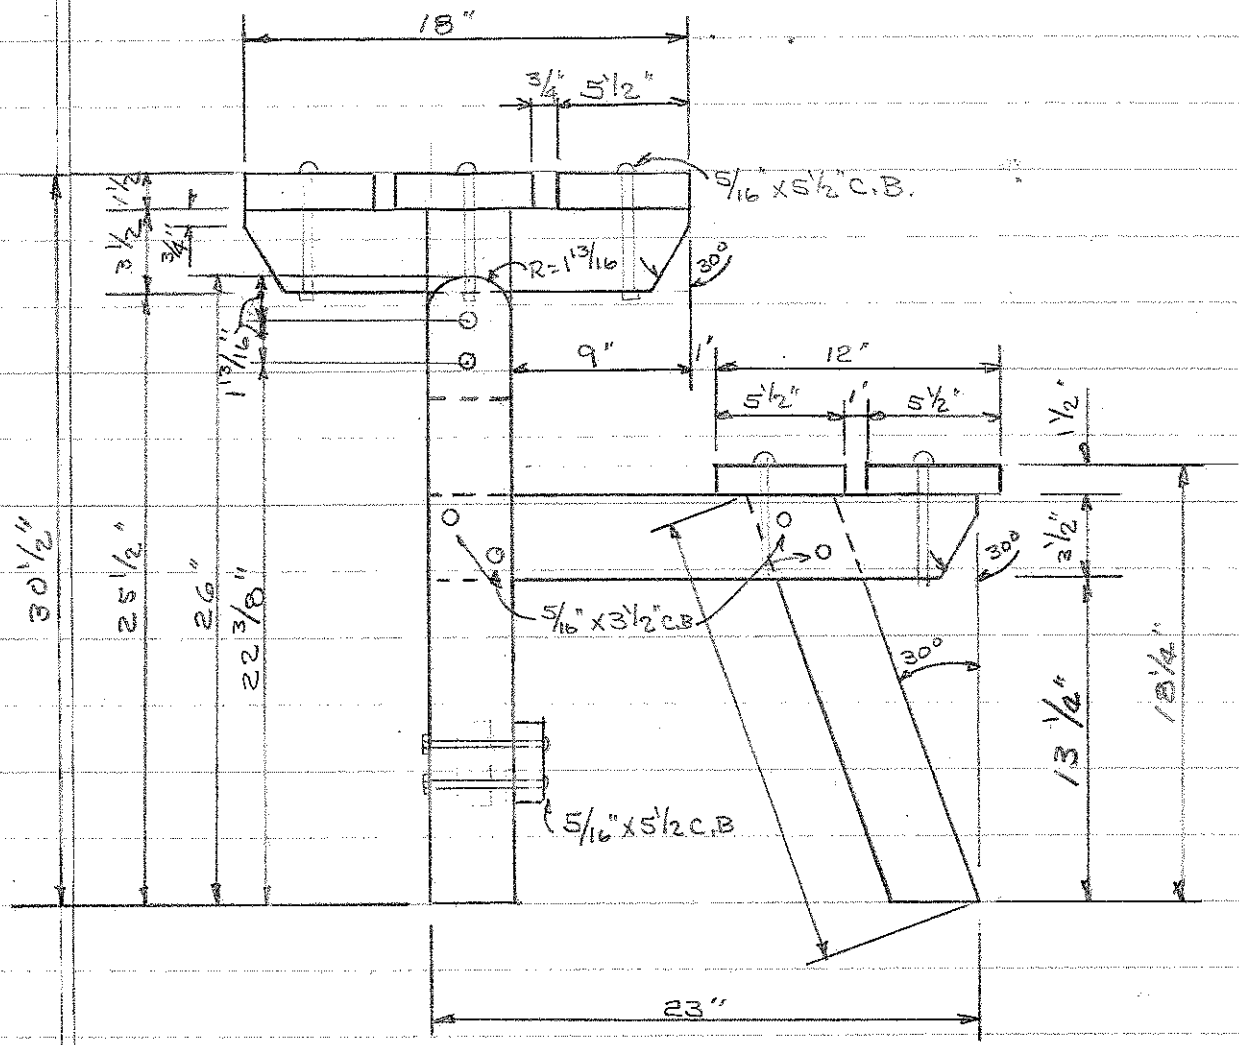

10 - 5/16" x 3 1/2" C.B
 14 - 5/16" x 5 1/2" C.B