




**Yard Swing - Purchased 1971 by Wilma,
Stand Constructed in 1975 by Malcolm**

Photo taken 1993

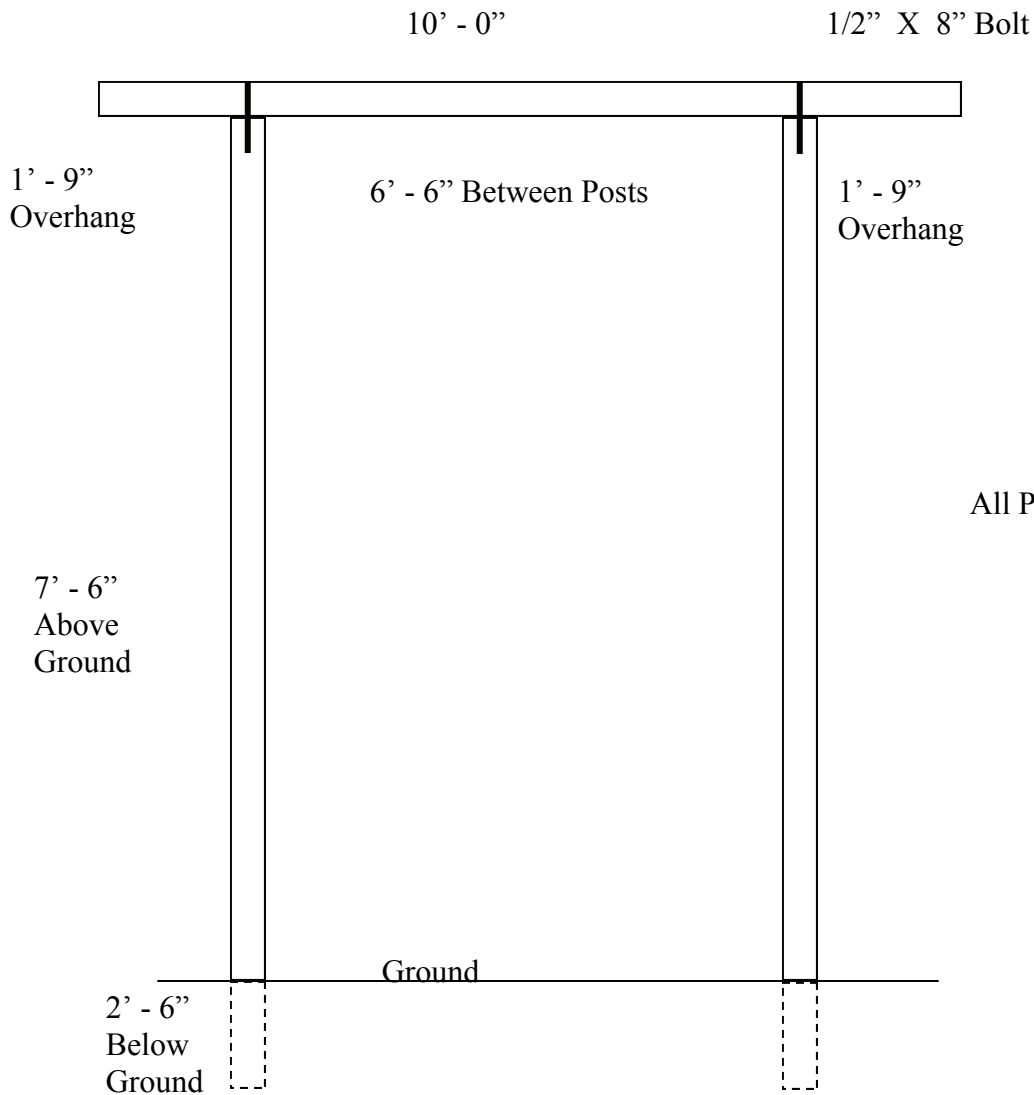

All Post are Treated 4" X 6" Timbers

Yard Swing
Date Approx 1975
By
Malcolm N. Beasley I
Page 1 of 1