


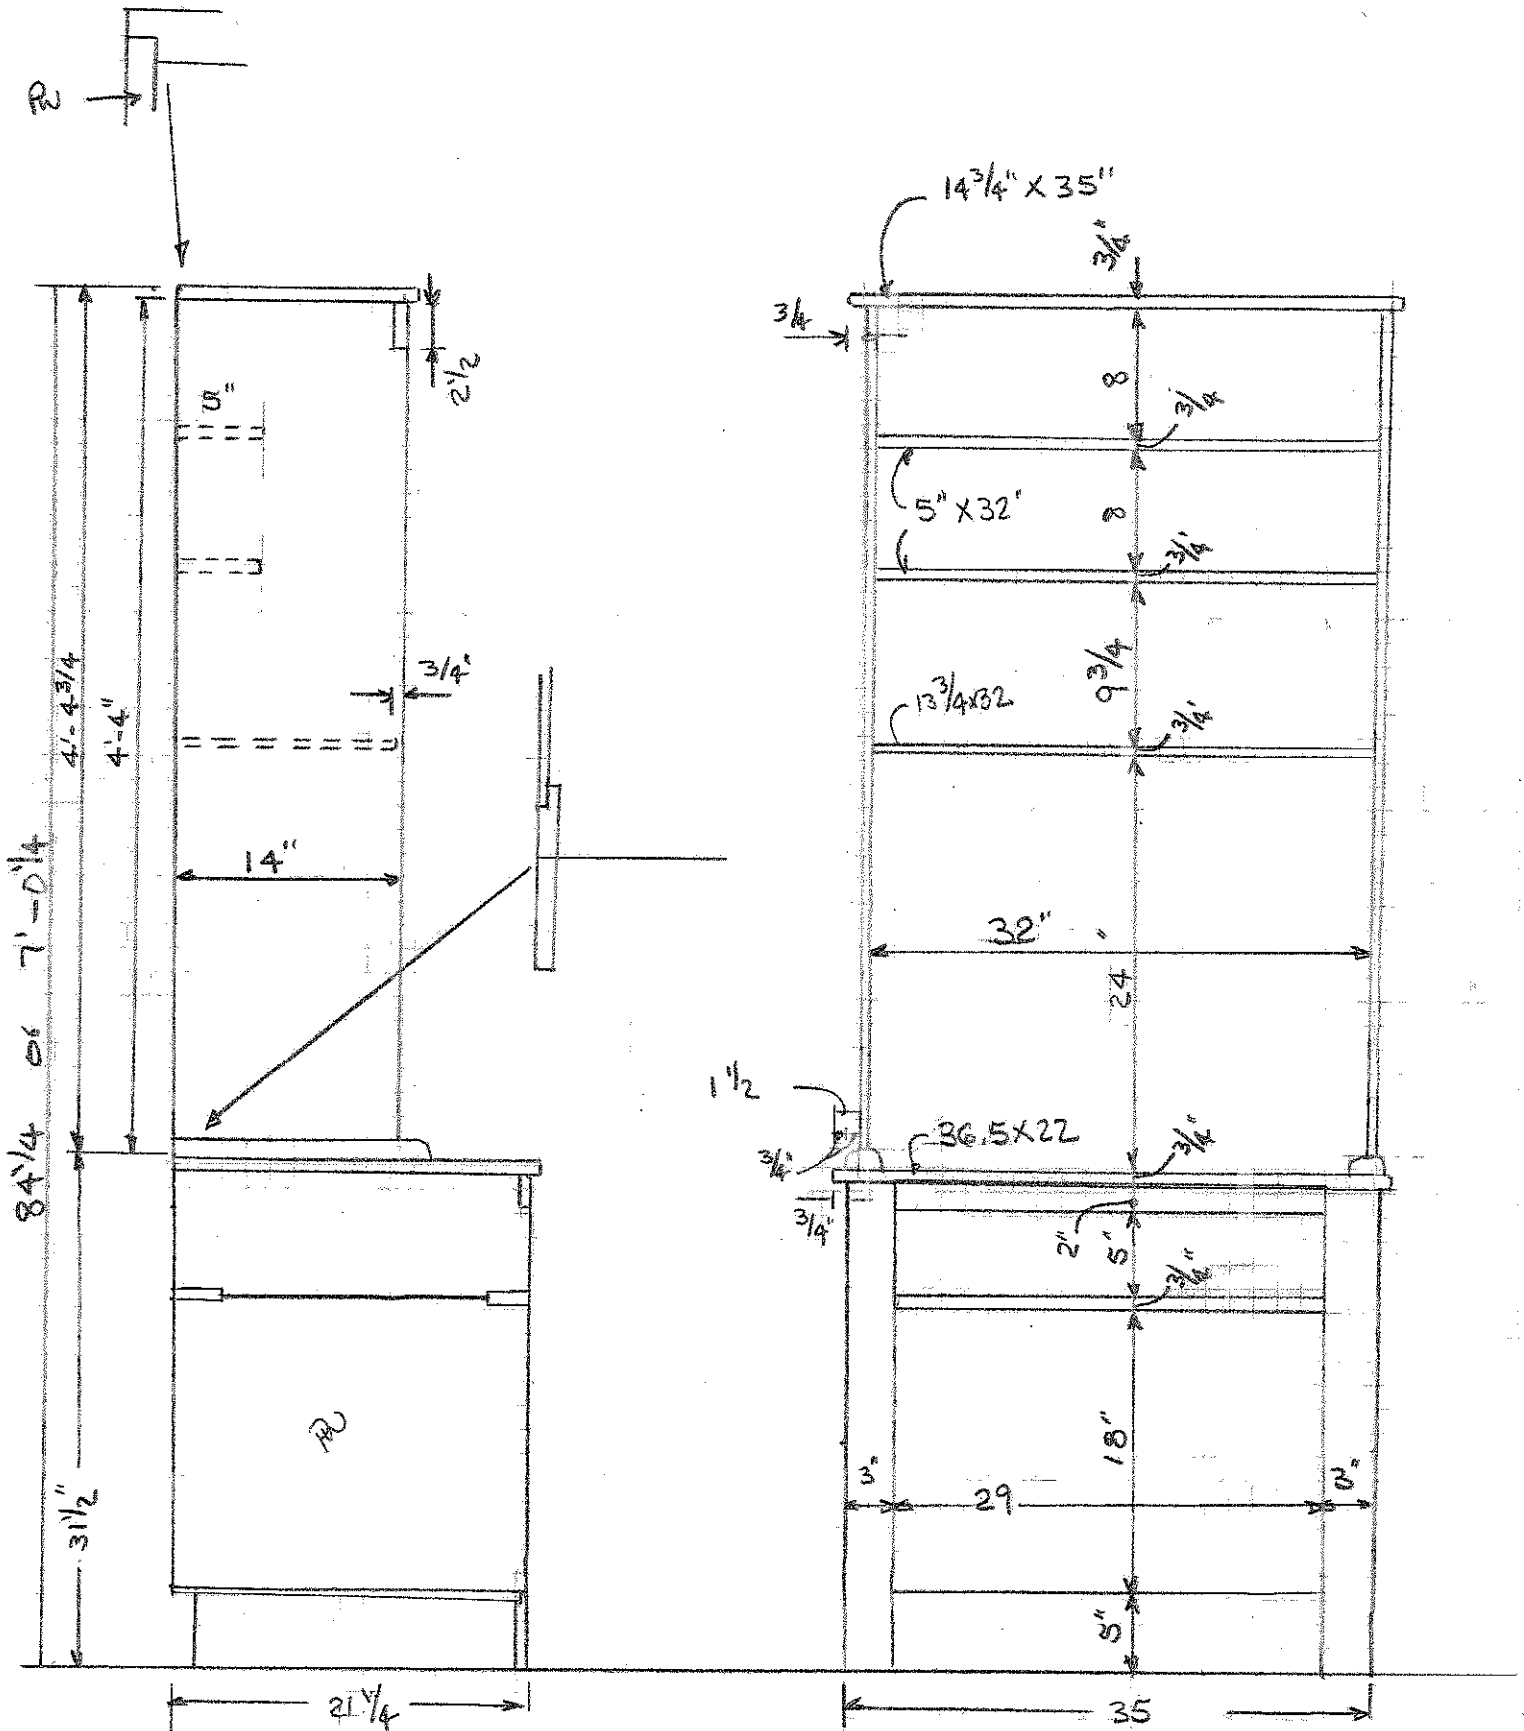


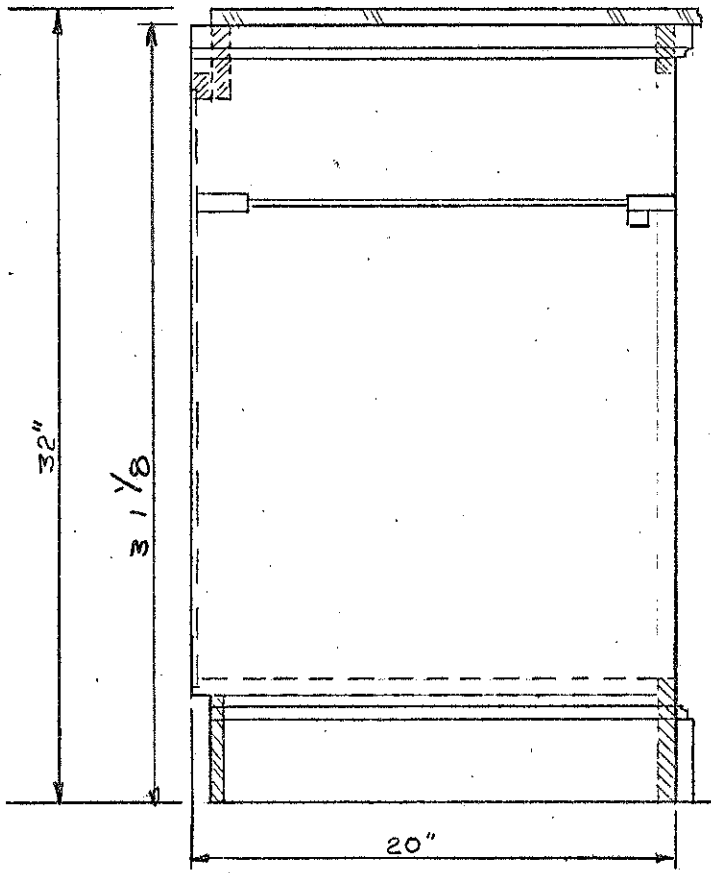


T V Cabinet Downstairs
By
Malcolm N. Beasley
1985

Malcolm & Wilma - Entertainment Center

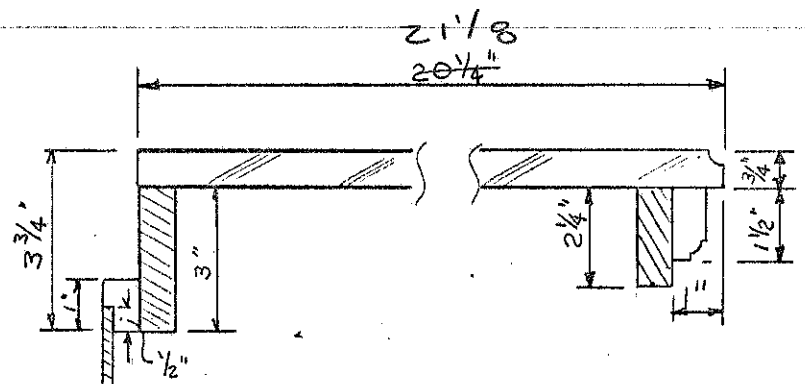

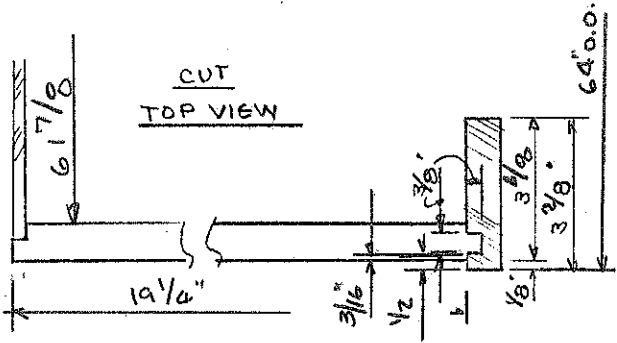

2 2 3 3/16" High
x 62 1/4" wide

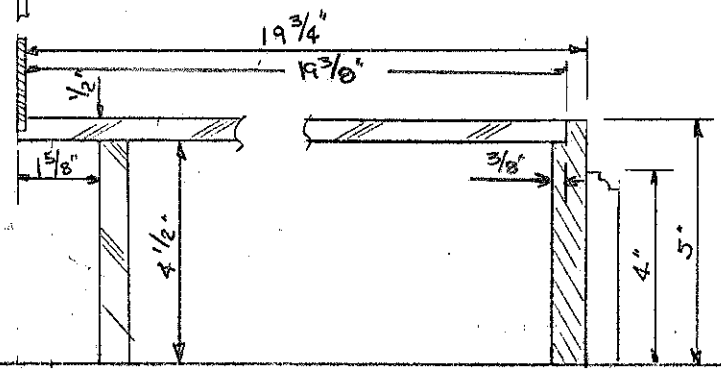

SIDE VIEW

CUT
SIDE VIEW