

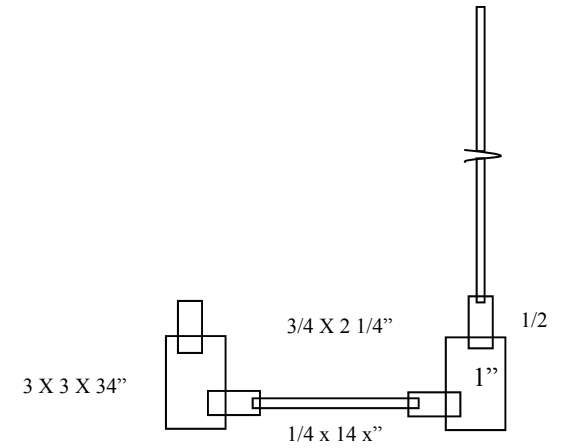
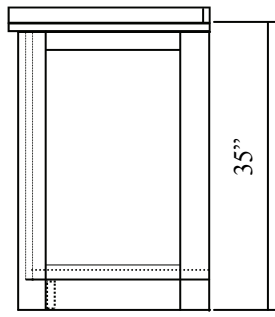
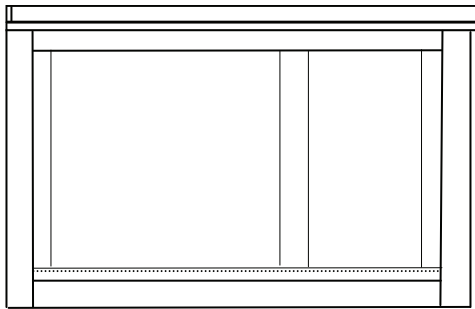





 

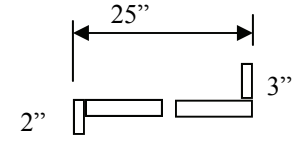


**Porch Sink by Malcolm Beasley 2005**

Top  $76.5'' + 20'' = 8'$

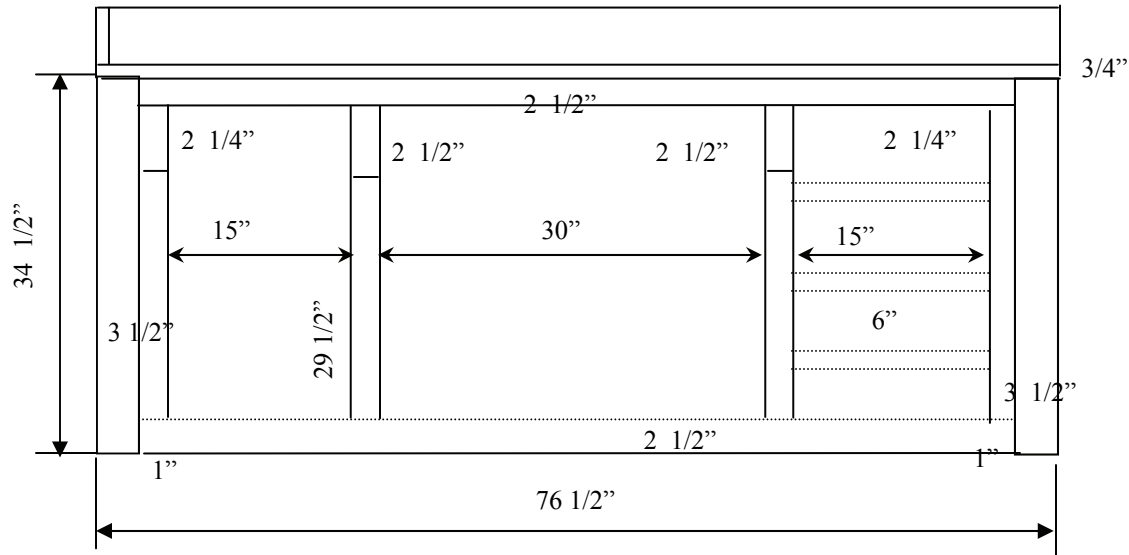

**POARCH SINK**  
 March 2006  
 By  
 Malcolm N. Beasley I  
 Page 1 of 1

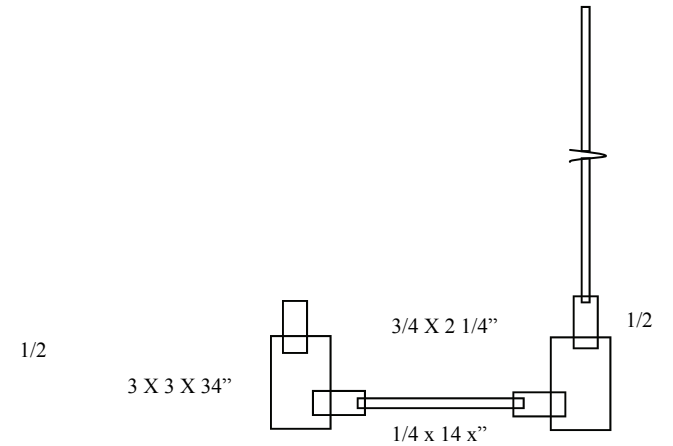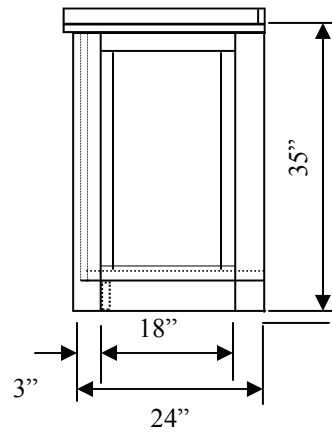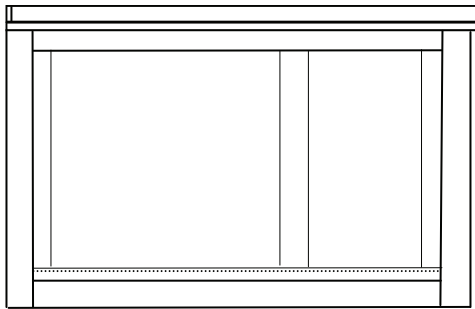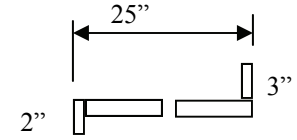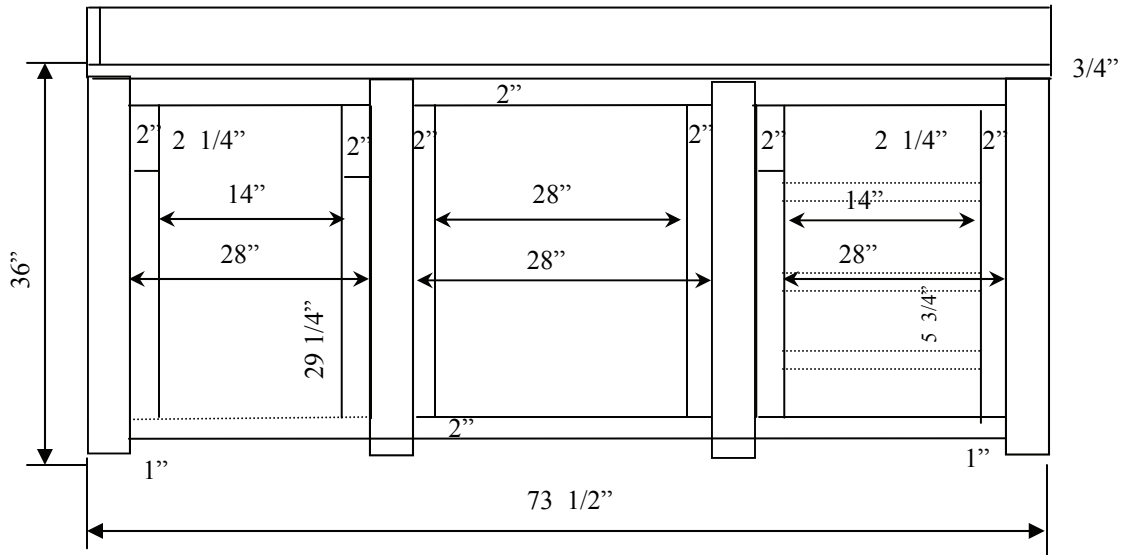

**POARCH SINK**  
 March 2006  
 By  
 Malcolm N. Beasley I  
 Page 1 of 1