


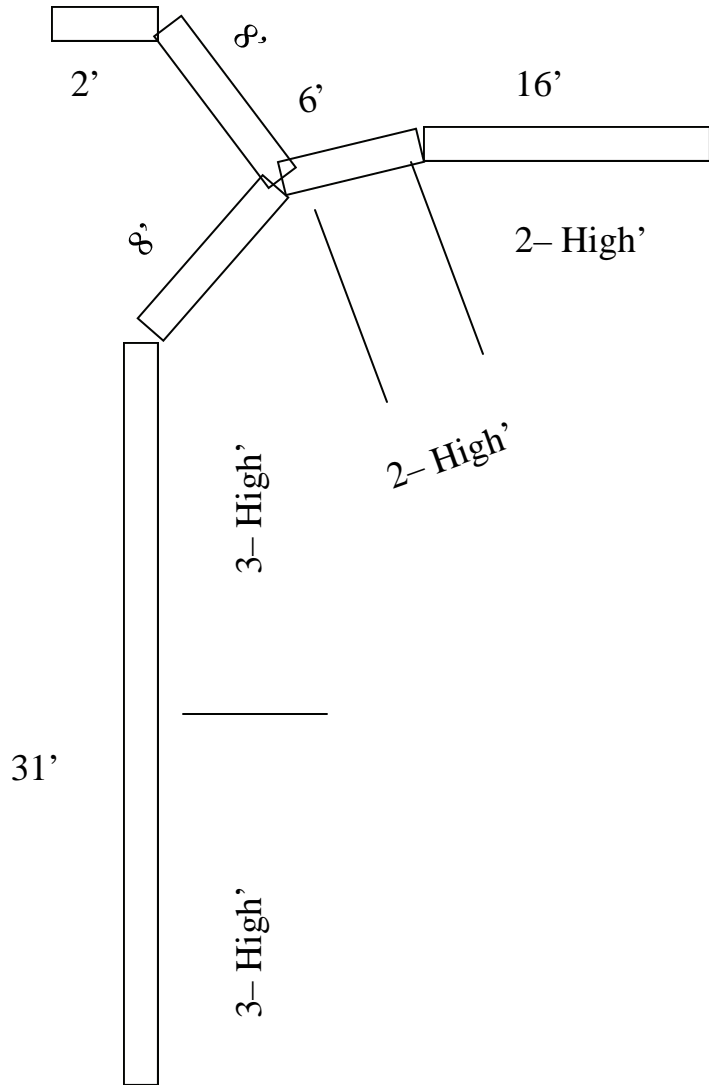

Retaining Wall, By Malcolm Beasley, 4-2008



Bill of Materials



250—8" Blocks at Price \$550

Retaining Wall
April 2008
By
Malcolm N. Beasley I
Page 1 of 1