


Handrail Patio Side

By Malcolm Beasley Sr
Feb 2008



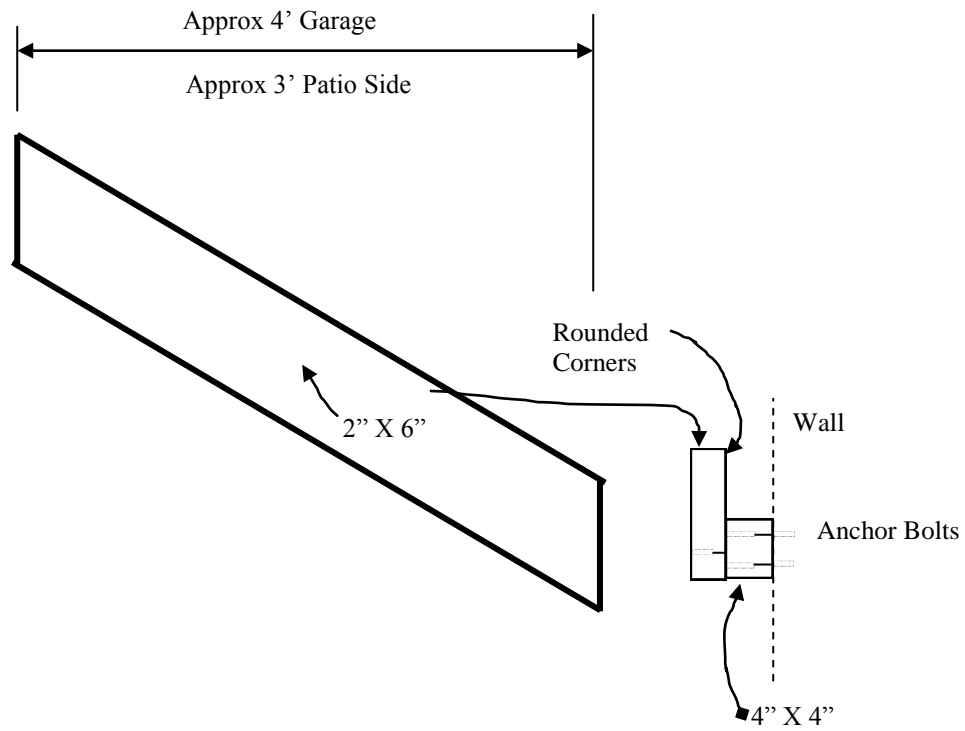

Stair Rail As-Built

2-2008

By

Malcolm N. Beasley I

Page 2 of 2