



Rt. Side Shelf
 By
Malcolm N. Beasley I
 5-23-2012 Page 1 of 1

55 Inches

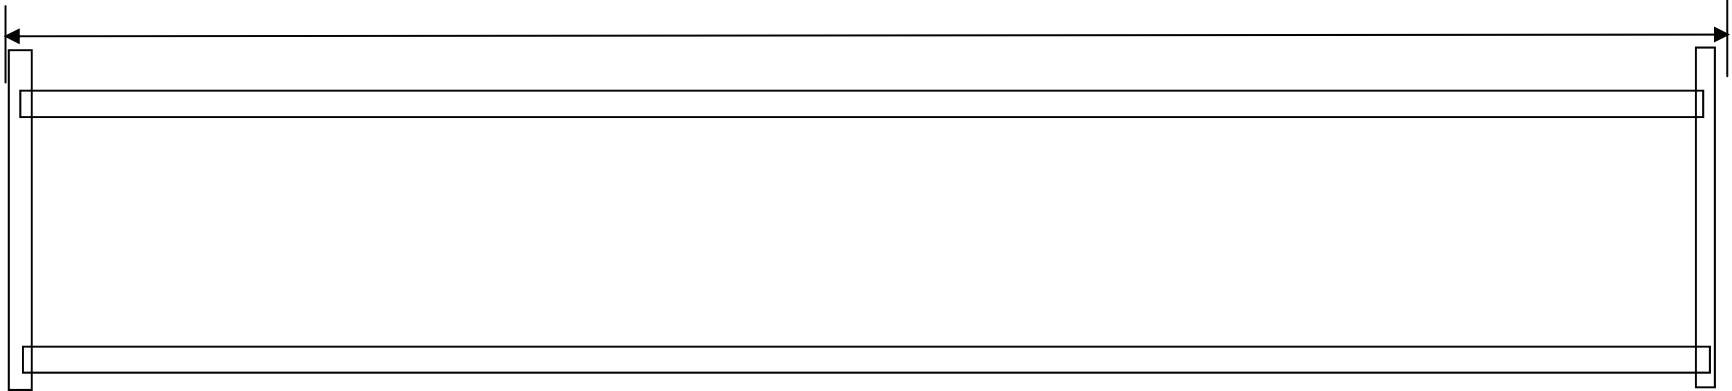

6" Square

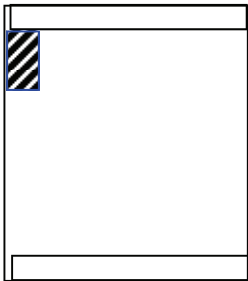

Top Shelf

By
Malcolm N. Beasley I
5-23-2012 Page 1 of 1