

Wilma's Wasted Space Thread Holder


4-28-2014



Wasted Space Thread Holder

Malcolm N. Beasley I

Page 1 of 2

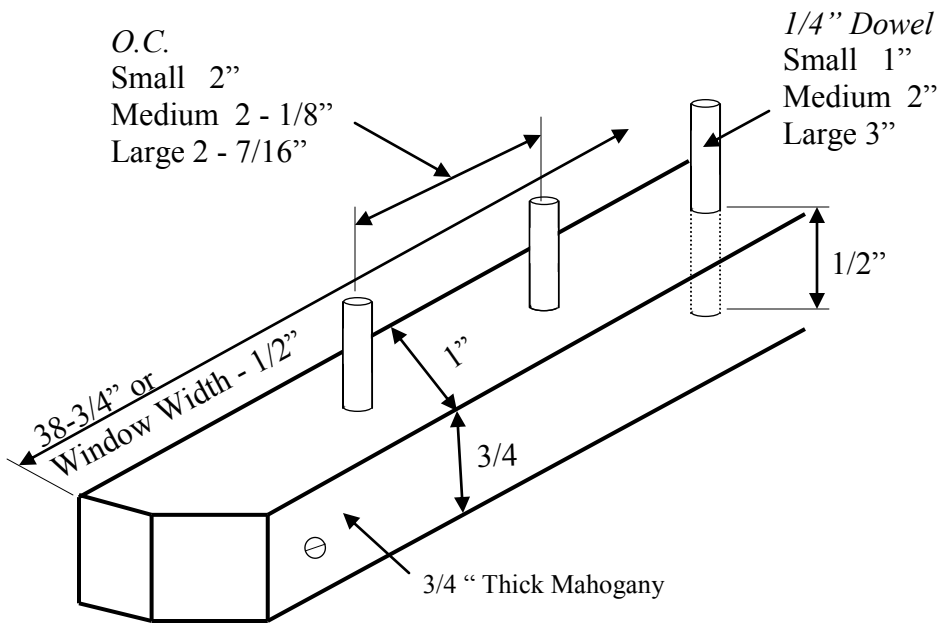

Detail Drawing

